DRAWING NUMBER: MD-216-3120-EG-ST-GAD-2026 | REV: A01

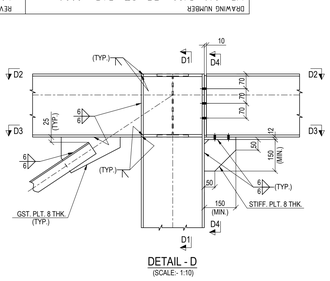

DETAIL - D
(SCALE- 1:10)

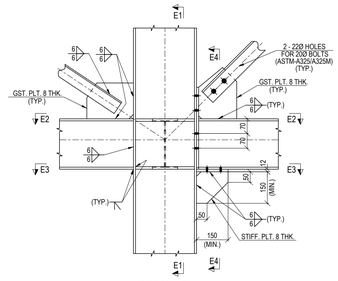

DETAIL - E
(SCALE- 1:10)

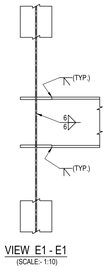

VIEW E1 - E1
(SCALE- 1:10)

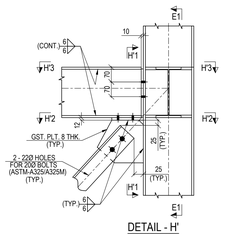

DETAIL - H'
(SCALE- 1:10)

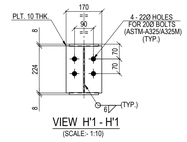

VIEW H'1 - H'1
(SCALE- 1:10)

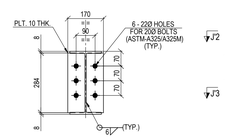

VIEW J'1 - J'1
(SCALE- 1:10)

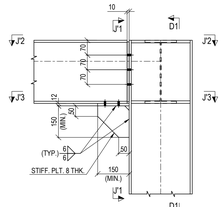

DETAIL - J'
(SCALE- 1:10)

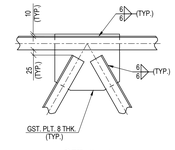

DETAIL - J
(SCALE- 1:10)

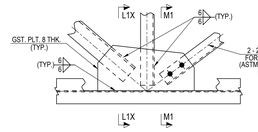

DETAIL - N
(SCALE- 1:10)

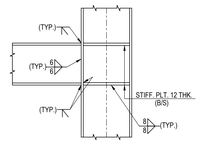

DETAIL - P
(SCALE- 1:10)

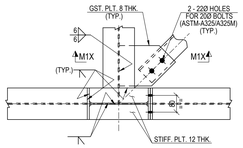

PLAN D2 - D2
(SCALE- 1:10)

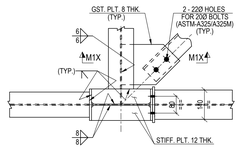

PLAN E2 - E2
(SCALE- 1:10)

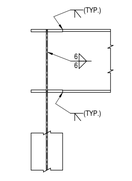

VIEW D1 - D1
(SCALE- 1:10)

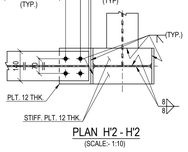

PLAN H'2 - H'2
(SCALE- 1:10)

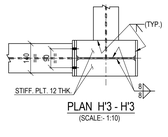

PLAN H'3 - H'3
(SCALE- 1:10)

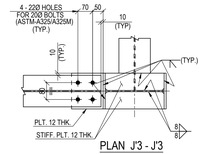

PLAN J'3 - J'3
(SCALE- 1:10)

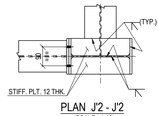

PLAN J'2 - J'2
(SCALE- 1:10)

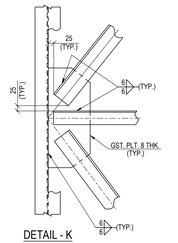

DETAIL - K
(SCALE- 1:10)

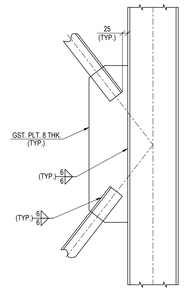

DETAIL - H
(SCALE- 1:10)

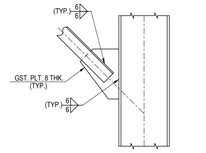

DETAIL - Q
(SCALE- 1:10)

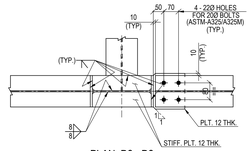

PLAN D3 - D3
(SCALE- 1:10)

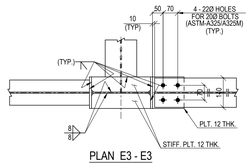

PLAN E3 - E3
(SCALE- 1:10)

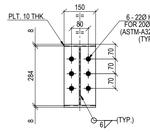

VIEW D4 - D4
(SCALE- 1:10)

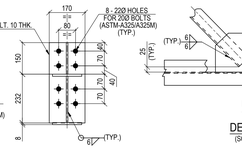

VIEW E4 - E4
(SCALE- 1:10)

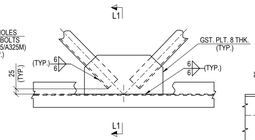

DETAIL - L
(SCALE- 1:10)

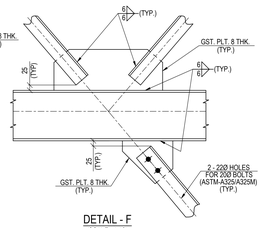

DETAIL - F
(SCALE- 1:10)

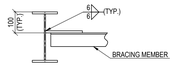

VIEW L1 - L1 (AS DRN.)
VIEW L1X - L1X (OPP. HAND)
(SCALE- 1:10)

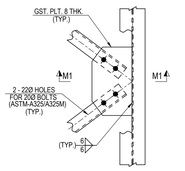

DETAIL - M
(SCALE- 1:10)

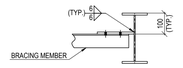

VIEW M1 - M1 (AS DRN.)
VIEW M1X - M1X (OPP. HAND)
(SCALE- 1:10)

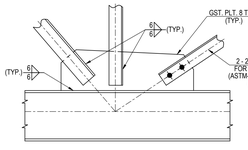

DETAIL - G
(SCALE- 1:10)

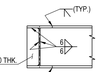

VIEW X1 - X1
(SCALE- 1:10)

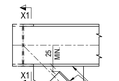

DETAIL - X
(SCALE- 1:10)

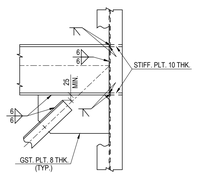

DETAIL - Y
(SCALE- 1:10)

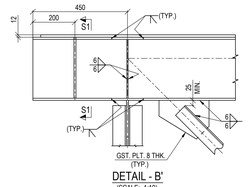

DETAIL - B'
(SCALE- 1:10)

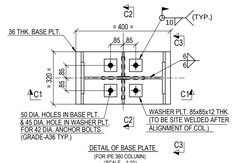

DETAIL OF BASE PLATE.
(FOR PE 360 COLUMN)
(SCALE 1:10)

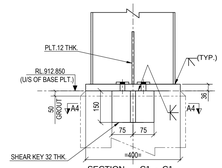

SECTION C1 - C1
(SCALE 1:10)

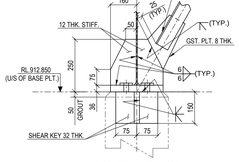

SECTION C2 - C2
(SCALE 1:10)

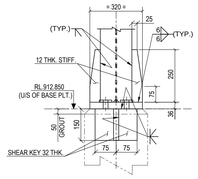

SECTION C3 - C3
(SCALE 1:10)

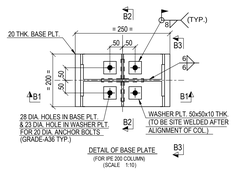

DETAIL OF BASE PLATE.
(FOR PE 200 COLUMN)
(SCALE 1:10)

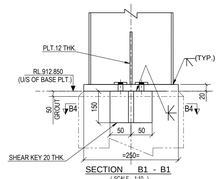

SECTION B1 - B1
(SCALE 1:10)

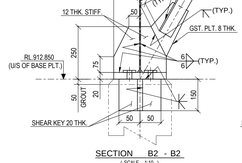

SECTION B2 - B2
(SCALE 1:10)

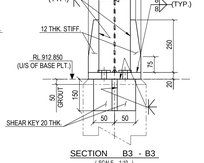

SECTION B3 - B3
(SCALE 1:10)

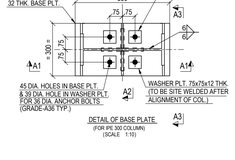

DETAIL OF BASE PLATE.
(FOR PE 300 COLUMN)
(SCALE 1:10)

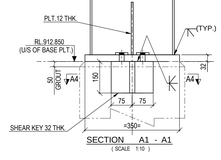

SECTION A1 - A1
(SCALE 1:10)

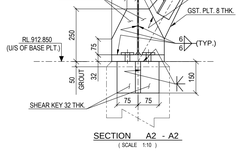

SECTION A2 - A2
(SCALE 1:10)

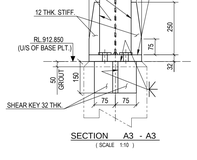

SECTION A3 - A3
(SCALE 1:10)

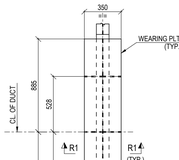

DETAIL - R
(SCALE- 1:20)

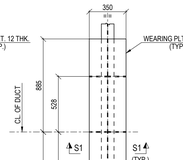

DETAIL - S
(SCALE- 1:20)

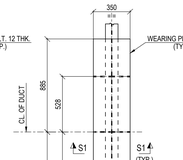

DETAIL - T
(SCALE- 1:20)

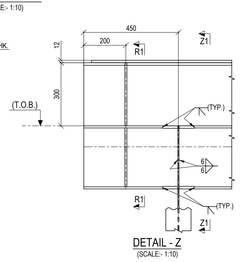

DETAIL - Z
(SCALE- 1:10)

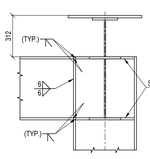

VIEW Z1 - Z1
(SCALE- 1:10)

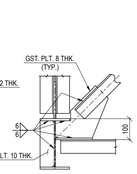

DETAIL - D'
(SCALE- 1:10)

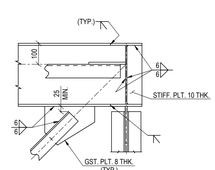

DETAIL - C'
(SCALE- 1:10)

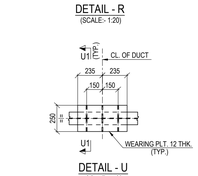

DETAIL - U
(SCALE- 1:20)

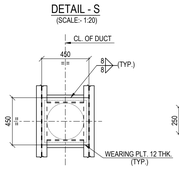


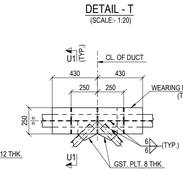


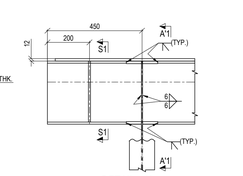

DETAIL - A'
(SCALE- 1:10)

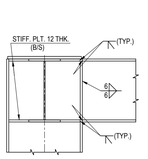

VIEW A'1 - A'1
(SCALE- 1:10)

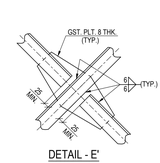

DETAIL - E'
(SCALE- 1:10)

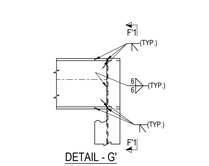

DETAIL - G'
(SCALE- 1:10)

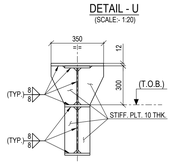

VIEW R1 - R1
(SCALE- 1:10)

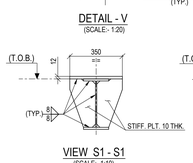

VIEW S1 - S1
(SCALE- 1:10)

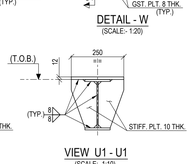

VIEW U1 - U1
(SCALE- 1:10)

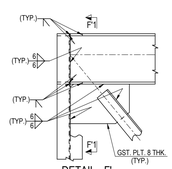

DETAIL - F'
(SCALE- 1:10)

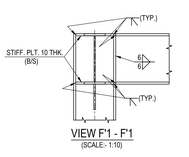

VIEW F'1 - F'1
(SCALE- 1:10)

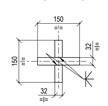

PLAN A4 - A4
(SCALE 1:10)

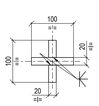

PLAN B4 - B4
(SCALE 1:10)

NOTES:

1. ALL DIMENSIONS & CO-ORDINATES ARE IN MILLIMETER AND LEVELS ARE IN METER UNO.
2. ANCHOR BOLT MATERIAL SHALL BE AS PER ASTM F 1554 Gr.36.
3. SIZE OF WELD SHALL BE DECIDED BASED ON LESSER THICKNESS OF THE JOINED MEMBER (UNLESS NOTED OTHERWISE).
4. ALL WELDS SHALL BE OF SHOP QUALITY & TO BE TESTED AS PER QUALITY ASSURANCE PLAN.
5. ALL PERMANENT STRUCTURAL BOLTS CONFORM TO ASTM A 325M.
6. PAINTING ON STRUCTURES WILL BE AS PER DESIGN BASIS REPORT (DBR).
7. FOR SPLICE DETAIL REFER DRAWING NO. (MD-216-1000-EG-ST-DED-1011)

LEGENDS:-

TOB - TOP OF BEAM
U/S - UNDER SIDE
CL. - CENTER LINE
TYP. - TYPICAL
PLT. - PLATE
THK. - THICKNESS
FGL - FINISHED GROUND LEVEL
B/S - BOTH SIDE
GST. - GUSSET
STIFF. - STIFFNER
CONT. - CONTINUE
CONN. - CONNECTION

DOCUMENT NUMBER	REFERENCE DOCUMENTS	REV	DATE	REVISION DESCRIPTION	DRN	CHK	ENG	APP	EMP
MD-216-1000-EG-ST-CRT-1001	CIVIL,STRUCTURAL AND ARCHITECTURAL DESIGN CRITERIA	A01	10/08/2020	ISSUED FOR REFERENCE	HSK	SBY	RPK	PRI	

DOCUMENT NUMBER	REFERENCE DOCUMENTS	REV	DATE	REVISION DESCRIPTION	DRN	CHK	ENG	APP	EMP

RESERVED FOR VENDOR LOGO AND DRAWING NUMBER

LARSEN & TOUBRO

This drawing is the property of LARSEN & TOUBRO and must not be passed on to any person or body not authorized by us to receive it nor be copied or otherwise made use either in full or in part by such person or body without our prior permission in writing.

Outotec

The content of these documents are the sole property of Outotec Oyj. Any rights not expressly granted herein are reserved. Reproduction, transfer or distribution of part or all of the contents in any form without prior written permission of Outotec is prohibited.

MA'ADEN معادن
Saudi Arabian Mining Company شركة معادن العربية السعودية

This document and the information contained herein is Ma'aden proprietary know-how. This document or any part thereof should not be reproduced, stored in a retrieval system or transmitted by any means, electronic or otherwise, or divulged without prior written permission of Ma'aden.

LARSEN & TOUBRO DRAWING NUMBER			REVISION
019045_080_S_G_27013_007			0
OUTOTEC DRAWING NUMBER		DOCUMENT ID	REVISION
900707__GAU01__ZC01__MTL01__31289		OU100692467	0
DRAWN	HSK	01/08/2020	MANSOURAH - MASSARAH GOLD PROJECT
CHECKED	SBY	03/08/2020	GENERAL ARRANGEMENT DRAWING
ENGINEER	RPK	04/08/2020	SCREEN BUILDING
APPROVED	PRI	06/08/2020	DETAIL OF DEDUSTING DUCT SUPPORT
EMPLOYER			
SCALE 1 : 10 & 20		A0	DRAWING NUMBER: MD-216-3120-EG-ST-GAD-2026 REV: A01

DRAWING NUMBER: MD-216-3130-EG-ST-GAD-1011 | REV: D01

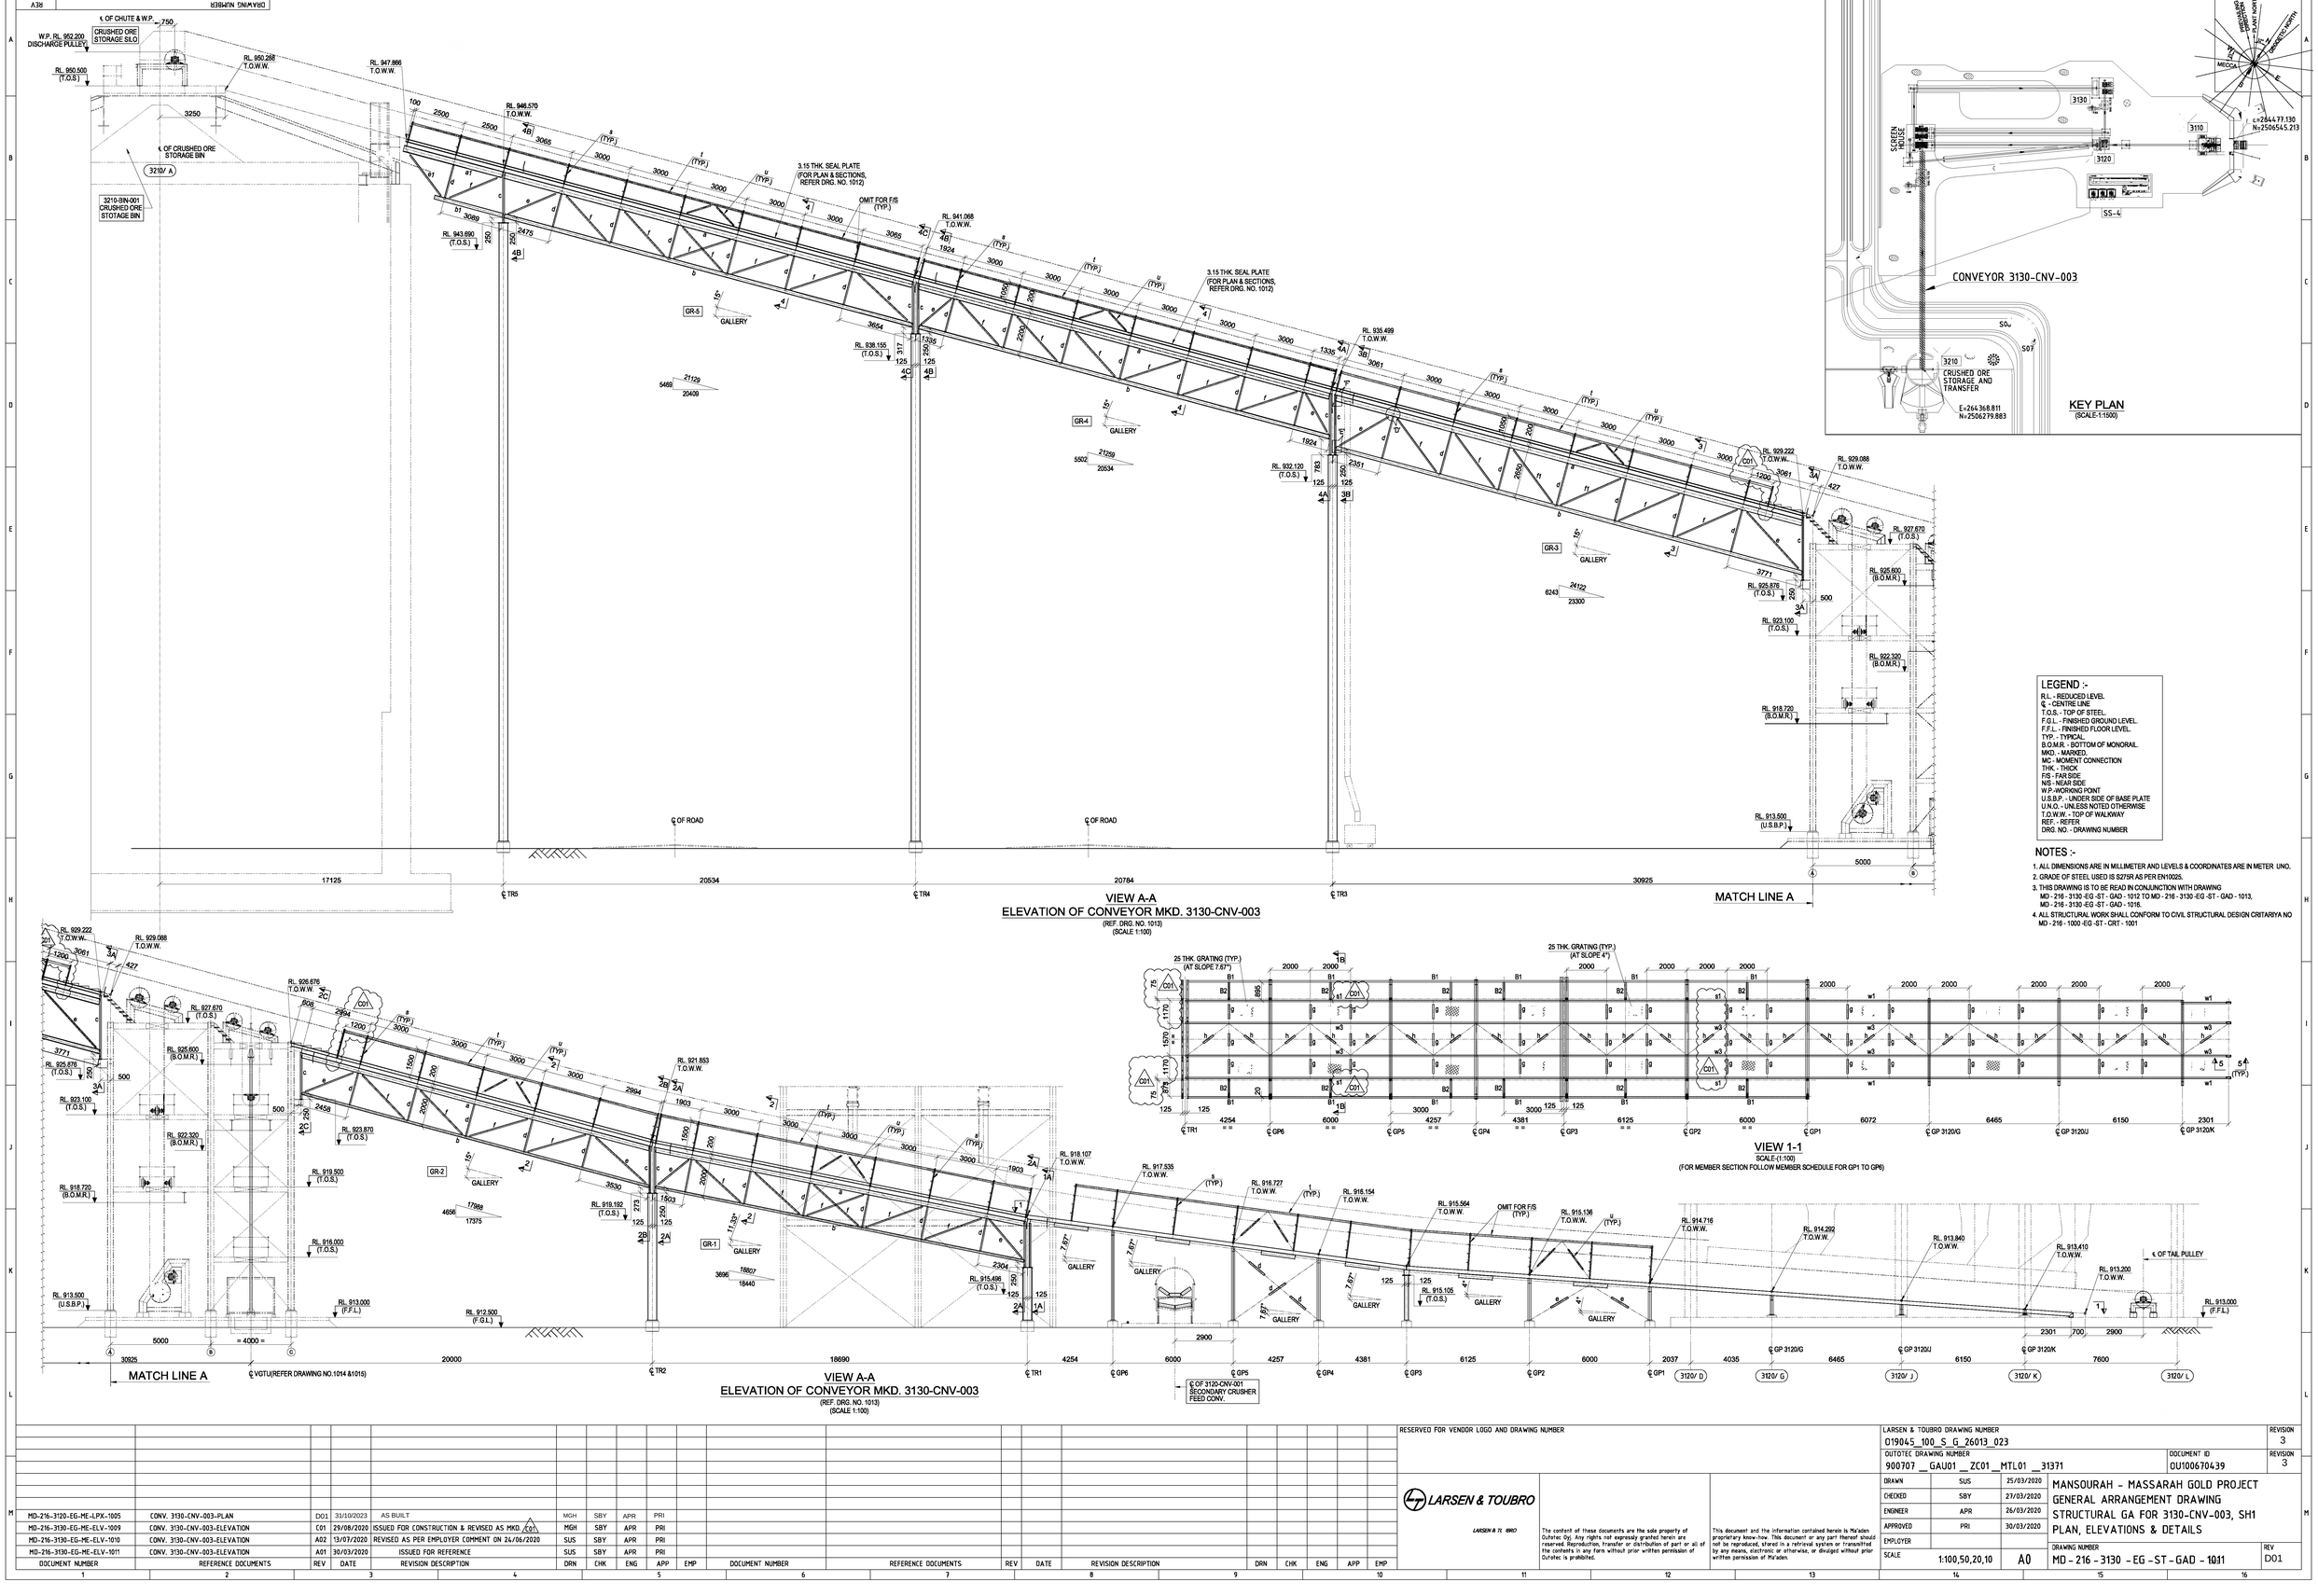

LEGEND :-

RL - RECDUCED LEVEL
℄ - CENTRE LINE
T.O.S. - TOP OF STEEL
F.G.L. - FINISHED GROUND LEVEL.
F.F.L. - FINISHED FLOOR LEVEL.
TYP. - TYPICAL
B.O.M.R. - BOTTOM OF MONORAIL.
MKD. - MARKED.
MC - MOMENT CONNECTION
THK. - THICK
F/S - FAR SIDE
N/S - NEAR SIDE
W.P.-WORKING POINT
U.S.B.P. - UNDER SIDE OF BASE PLATE
U.N.O. - UNLESS NOTED OTHERWISE
T.O.W.W. - TOP OF WALKWAY
REF. - REFER
DRG. NO. - DRAWING NUMBER

NOTES :-

1. ALL DIMENSIONS ARE IN MILLIMETER AND LEVELS & COORDINATES ARE IN METER UNO.
2. GRADE OF STEEL USED IS S275R AS PER EN10025.
3. THIS DRAWING IS TO BE READ IN CONJUNCTION WITH DRAWING MD - 216 - 3130 -EG -ST - GAD - 1012 TO MD - 216 - 3130 -EG -ST - GAD - 1013, MD - 216 - 3130 -EG -ST - GAD - 1015.
4. ALL STRUCTURAL WORK SHALL CONFORM TO CIVIL STRUCTURAL DESIGN CRITARIYA NO MD - 216 - 1000 -EG -ST - CRT - 1001

DOCUMENT NUMBER	REFERENCE DOCUMENTS	REV	DATE	REVISION DESCRIPTION	DRN	CHK	ENG	APP	EMP
MD-216-3120-EG-ME-LPX-1005	CONV. 3130-CNV-003-PLAN	D01	31/10/2023	AS BUILT	MGH	SBY	APR	PRI	
MD-216-3130-EG-ME-ELV-1009	CONV. 3130-CNV-003-ELEVATION	C01	29/08/2020	ISSUED FOR CONSTRUCTION & REVISED AS MKD. C01	MGH	SBY	APR	PRI	
MD-216-3130-EG-ME-ELV-1010	CONV. 3130-CNV-003-ELEVATION	A02	13/07/2020	REVISED AS PER EMPLOYER COMMENT ON 24/06/2020	SUS	SBY	APR	PRI	
MD-216-3130-EG-ME-ELV-1011	CONV. 3130-CNV-003-ELEVATION	A01	30/03/2020	ISSUED FOR REFERENCE	SUS	SBY	APR	PRI	

RESERVED FOR VENDOR LOGO AND DRAWING NUMBER

LARSEN & TOUBRO

LARSEN & TOUBRO

The content of these documents are the sole property of Outotec Oyj. Any rights not expressly granted herein are reserved. Reproduction, transfer or distribution of part or all of the contents in any form without prior written permission of Outotec is prohibited.

This document and the information contained herein is Ma'aden proprietary know-how. This document or any part thereof should not be reproduced, stored in a retrieval system or transmitted by any means, electronic or otherwise, or divulged without prior written permission of Ma'aden.

LARSEN & TOUBRO DRAWING NUMBER: 019045_100_S_G_26013_023 — REVISION: 3
OUTOTEC DRAWING NUMBER: 900707__GAU01__ZC01_MTL01__31371 — DOCUMENT ID: OU100670439 — REVISION: 3

DRAWN	SUS	25/03/2020
CHECKED	SBY	27/03/2020
ENGINEER	APR	26/03/2020
APPROVED	PRI	30/03/2020
EMPLOYER		
SCALE	1:100,50,20,10	A0

MANSOURAH - MASSARAH GOLD PROJECT
GENERAL ARRANGEMENT DRAWING
STRUCTURAL GA FOR 3130-CNV-003, SH1
PLAN, ELEVATIONS & DETAILS

DRAWING NUMBER: MD - 216 - 3130 - EG - ST - GAD - 1011 — REV: D01

DRAWING NUMBER: MD-216-3130-EG-ST-GAD-1013 REV D01

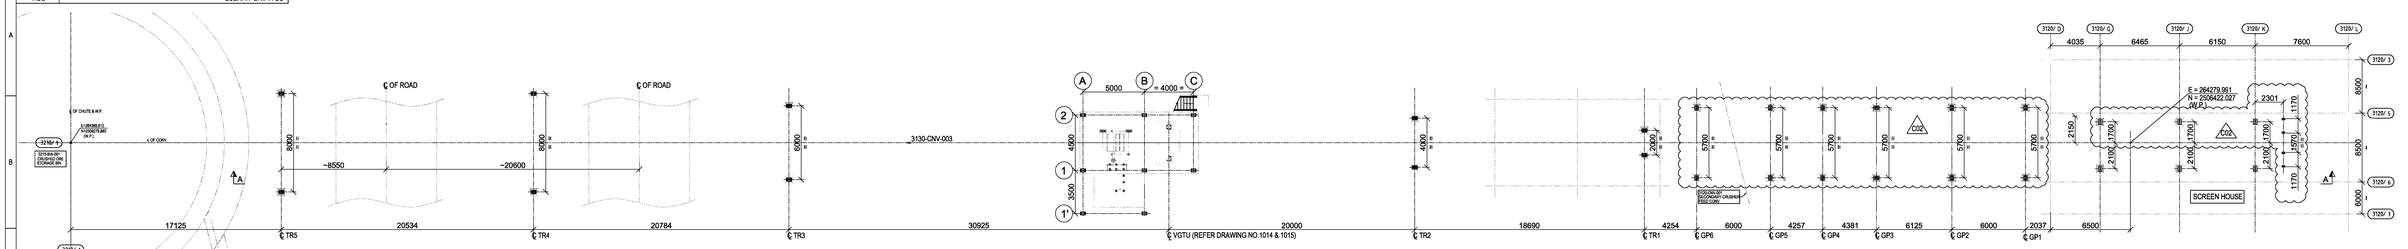

PLAN AT BASE PLATE LEVEL OF CONVEYOR MKD. 3130-CNV-003

(SCALE 1:175)

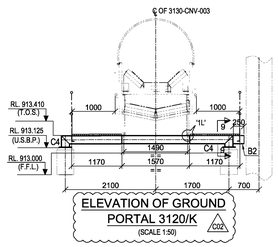

ELEVATION OF GROUND PORTAL MKD. 3120/K

(SCALE 1:50) C02

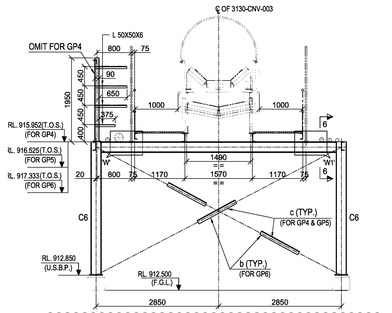

ELEVATION OF GROUND PORTAL MKD. GP4, GP5 & GP6

(SCALE 1:50) C02

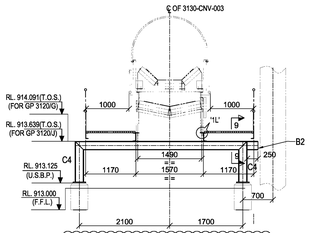

ELEVATION OF GROUND PORTAL MKD. 3120/G & 3120/J

(SCALE 1:50) C02

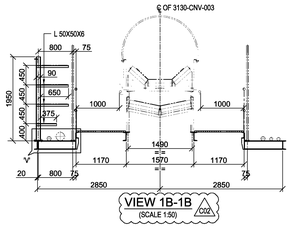

VIEW 1B-1B

(SCALE 1:50) C02

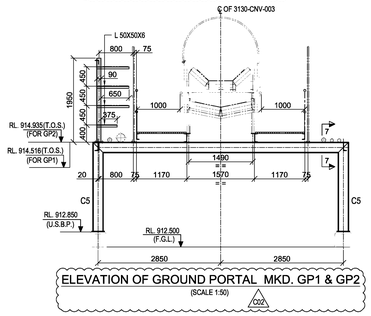

ELEVATION OF GROUND PORTAL MKD. GP1 & GP2

(SCALE 1:50) C02

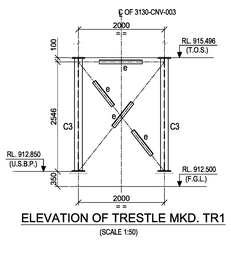

ELEVATION OF TRESTLE MKD. TR1

(SCALE 1:50)

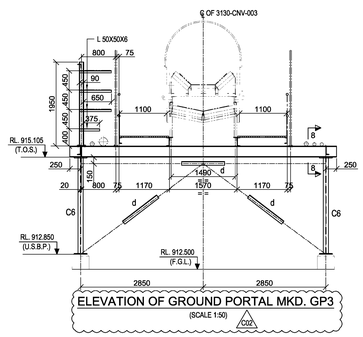

ELEVATION OF GROUND PORTAL MKD. GP3

(SCALE 1:50) C02

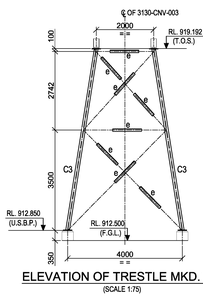

ELEVATION OF TRESTLE MKD. TR2

(SCALE 1:75)

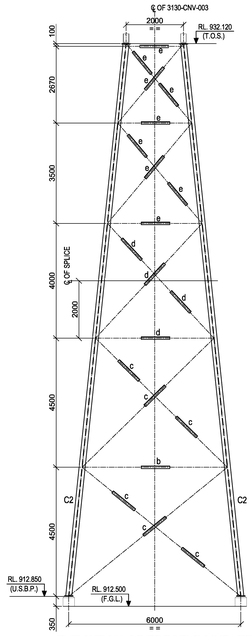

ELEVATION OF TRESTLE MKD. TR3

(SCALE 1:75)

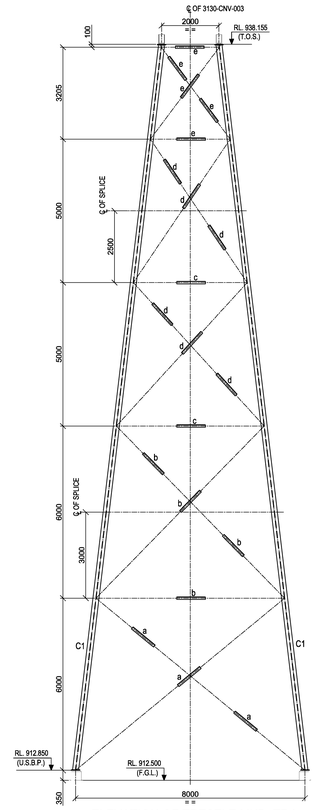

ELEVATION OF TRESTLE MKD. TR4

(SCALE 1:75)

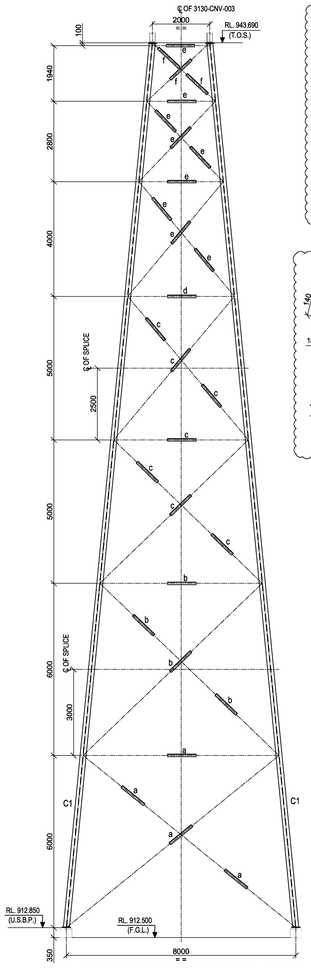

ELEVATION OF TRESTLE MKD. TR5

(SCALE 1:75)

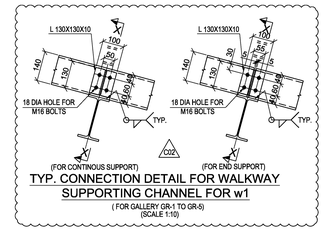

TYP. CONNECTION DETAIL FOR WALKWAY SUPPORTING CHANNEL FOR w1

(FOR GALLERY GR-1 TO GR-5)

(SCALE 1:10)

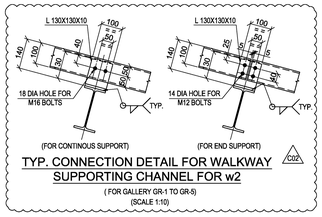

TYP. CONNECTION DETAIL FOR WALKWAY SUPPORTING CHANNEL FOR w2

(FOR GALLERY GR-1 TO GR-5)

(SCALE 1:10) C02

SCHEDULE OF MEMBERS FOR GP1 TO GP6, GP 3120/G TO GP 3120/K, TR1 TO TR5

MEMBER MARKED	MEMBER	SECTON	FACTORED AXIAL FORCE(KN)	FACTORED SHEAR FORCE(KN)	REMARKS
C1	IPE 550	I	925	-	MATERIAL GRADE:S275 JR
C2	IPE 500	I	910	-	
C3	1. PL. 130X12 2. PL. 236X8	1 I 2	-	-	
C4	1. PL. 120X12 2. PL. 176X8	1 I 2	-	-	
C5	1. PL. 150X16 2. PL. 218X8	1 I 2	-	-	
C6	IPE 240	I	-	-	
B1	UPN 200	[	-	-	
B2	IPE 200	I	-	-	
a	2L 130X130X10	T	220	-	
b	2L 100X100X8	T	200	-	
c	2L 90X90X8	T	130	-	
d	2L 75X75X8	T	110	-	
e	2L 65X65X6	T	100	-	
f	2L 50X50X6	T	75	-	
g	L 50X50X6	L	-	-	
h	L 65X65X8	L	-	-	
s	UPN 100	[	-	-	
t	L 75X75X8	L	-	-	
u	L 50X50X6	L	-	-	
C02, w3	UPN 200	[	-	-	
C02, s1, w1	UPN 140	[	-	-	

ALL GUSSET PLATE ARE 8mm THK.
FOR DEVELOPING CONNECTIONS MEMBER END FORCES MENTIONED IN SCHEDULE OF MEMBERS SHALL BE FOLLOWED.
MINIMUM 6mm FILLET WELD OF 150 mm LENGTH SHALL BE PROVIDED FOR WELDED CONNECTION. FOR BOLTED CONNECTION, MINIMUM 2 Nos. M20 BOLTS SHALL BE PROVIDED.

TYP. CONNECTION DETAIL FOR WALKWAY SUPPORTING CHANNEL FOR w1 & S1

(FOR GP-1 TO GP-6)

(SCALE 1:10)

TYP. CONNECTION DETAIL FOR WALKWAY SUPPORTING CHANNEL FOR w3

(FOR GP-1 TO GP-6)

(SCALE 1:10)

SECTION X-X

(SCALE 1:10) C02

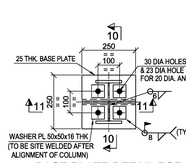

BASE PLATE DETAIL FOR 3120/G, 3120/J & 3120/K

(SCALE - 1:10)

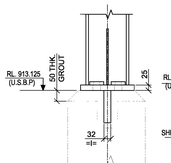

SECTION 10-10

(SCALE - 1:10)

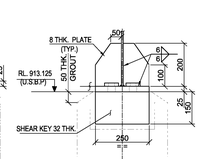

SECTION 11-11

(SCALE - 1:10)

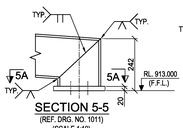

SECTION 5-5

(REF. DRG. NO. 1011)

(SCALE 1:10)

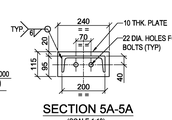

SECTION 5A-5A

(SCALE 1:10)

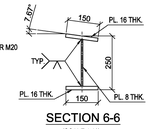

SECTION 6-6

(SCALE 1:10)

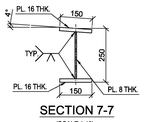

SECTION 7-7

(SCALE 1:10)

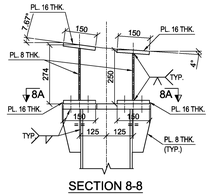

SECTION 8-8

(SCALE 1:10)

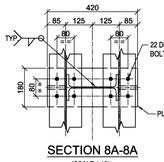

SECTION 8A-8A

(SCALE 1:10)

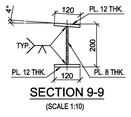

SECTION 9-9

(SCALE 1:10)

LEGEND :-

R.L. - REDUCED LEVEL
℄ - CENTRE LINE
T.O.S. - TOP OF STEEL.
F.G.L. - FINISHED GROUND LEVEL.
F.F.L. - FINISHED FLOOR LEVEL.
TYP. - TYPICAL.
B.O.M.R. - BOTTOM OF MONORAIL.
MKD. - MARKED.
MC - MOMENT CONNECTION
THK. - THICK
F/S - FAR SIDE
N/S - NEAR SIDE
W.P.-WORKING POINT
U.S.B.P. - UNDER SIDE OF BASE PLATE
U.N.O. - UNLESS NOTED OTHERWISE
T.O.W.W. - TOP OF WALKWAY
REF. - REFER
DRG. NO. - DRAWING NUMBER

NOTES :-

1. ALL DIMENSIONS ARE IN MILLIMETER AND LEVELS & COORDINATES ARE IN METER UNO.
2. GRADE OF STEEL USED IS S275R AS PER EN10025.
3. THIS DRAWING IS TO BE READ IN CONJUNCTION WITH DRAWING MD - 216 - 3130 -EG -ST - GAD - 1011, MD - 216 - 3130 -EG -ST - GAD - 1012, MD - 216 - 3130 -EG -ST - GAD - 1015,
4. ALL STRUCTURAL WORK SHALL CONFORM TO CIVIL STRUCTURAL DESIGN CRITARIYA NO MD - 216 - 1000 -EG -ST - CRT - 1001

DOCUMENT NUMBER	REFERENCE DOCUMENTS	REV	DATE	REVISION DESCRIPTION	DRN	CHK	ENG	APP	EMP
		D01	31/10/2023	AS BUILT	MGH	SBY	APR	PRI	
MD-216-3120-EG-ME-LPX-1005	CONV. 3130-CNV-003-PLAN	C02	29/08/2020	ISSUED FOR CONSTRUCTION & REVISED AS MKD. C02	MGH	SBY	APR	PRI	
MD-216-3130-EG-ME-ELV-1009	CONV. 3130-CNV-003-ELEVATION	C01	30/06/2020	ISSUED FOR CONSTRUCTION	SUS	SBY	APR	PRI	
MD-216-3130-EG-ME-ELV-1010	CONV. 3130-CNV-003-ELEVATION	A02	01/06/2020	REVISED AS PER EMPLOYER COMMENT ON 26/05/2020	SUS	SBY	APR	PRI	
MD-216-3130-EG-ME-ELV-1011	CONV. 3130-CNV-003-ELEVATION	A01	30/03/2020	ISSUED FOR REFERENCE	SUS	SBY	APR	PRI	

DOCUMENT NUMBER | REFERENCE DOCUMENTS | REV | DATE | REVISION DESCRIPTION | DRN | CHK | ENG | APP | EMP

RESERVED FOR VENDOR LOGO AND DRAWING NUMBER

LARSEN & TOUBRO

LARSEN & TOUBRO

The content of these documents are the sole property of Outotec Oyj. Any rights not expressly granted herein are reserved. Reproduction, transfer or distribution of part or all of the contents in any form without prior written permission of Outotec is prohibited.

This document and the information contained herein is Malden proprietary know-how. This document or any part thereof should not be reproduced, stored in a retrieval system or transmitted by any means, electronic or otherwise, or divulged without prior written permission of Malden.

LARSEN & TOUBRO DRAWING NUMBER	019045_100_S_G_26013_025
REVISION	4
OUTOTEC DRAWING NUMBER	900707__GAU01__ZC01__MTL01__31304
DOCUMENT ID	OU100668056
REVISION	4

DRAWN	SUS	25/03/2020
CHECKED	SBY	27/03/2020
ENGINEER	APR	26/03/2020
APPROVED	PRI	30/03/2020
EMPLOYER		
SCALE	1:100,50,20,10	A0

MANSOURAH - MASSARAH GOLD PROJECT
GENERAL ARRANGEMENT DRAWING
STRUCTURAL GA FOR 3130-CNV-003, SH3
PLAN, ELEVATIONS & DETAILS

DRAWING NUMBER: MD - 216 - 3130 - EG - ST - GAD - 1013 REV: D01

DRAWING NUMBER: MD-216-3130-EG-ST-GAD-1016 REV D01

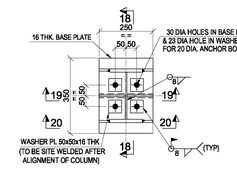

BASE PLATE DETAIL FOR GP1 & GP2
(SCALE - 1:10)

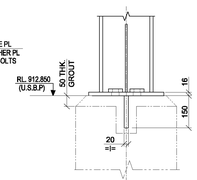

SECTION 18-18
(SCALE - 1:10)

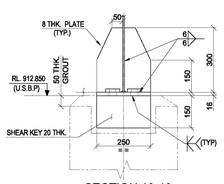

SECTION 19-19
(SCALE - 1:10)

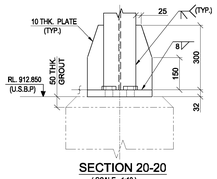

SECTION 20-20
(SCALE - 1:10)

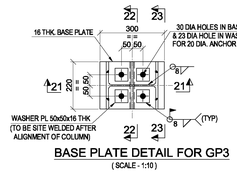

BASE PLATE DETAIL FOR GP3
(SCALE - 1:10)

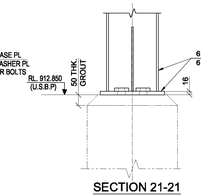

SECTION 21-21

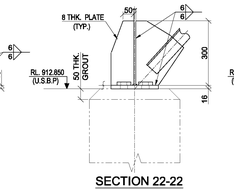

SECTION 22-22

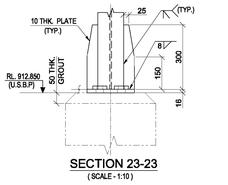

SECTION 23-23
(SCALE - 1:10)

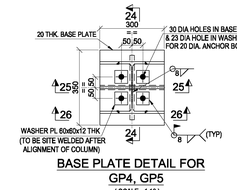

BASE PLATE DETAIL FOR GP4, GP5
(SCALE - 1:10)

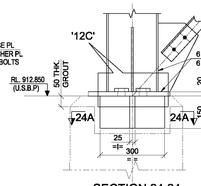

SECTION 24-24
(SCALE - 1:10)

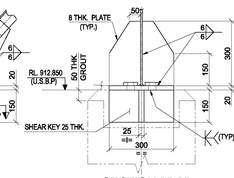

SECTION 25-25
(SCALE - 1:10)

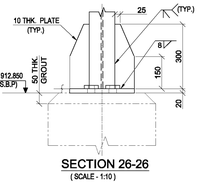

SECTION 26-26
(SCALE - 1:10)

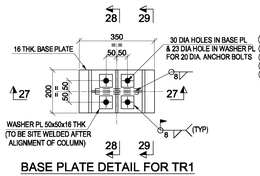

BASE PLATE DETAIL FOR TR1
(SCALE - 1:10)

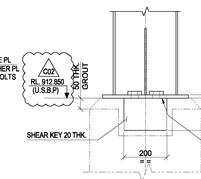

SECTION 27-27
(SCALE - 1:10)

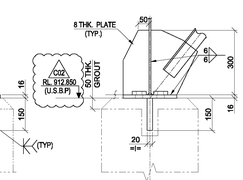

SECTION 28-28
(SCALE - 1:10)

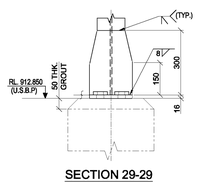

SECTION 29-29
(SCALE - 1:10)

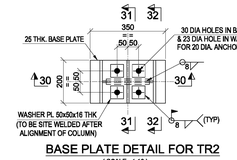

BASE PLATE DETAIL FOR TR2
(SCALE - 1:10)

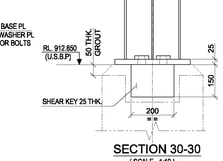

SECTION 30-30
(SCALE - 1:10)

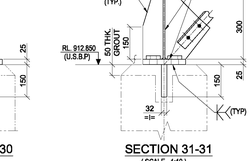

SECTION 31-31
(SCALE - 1:10)

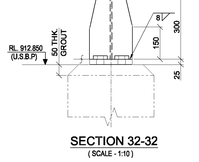

SECTION 32-32
(SCALE - 1:10)

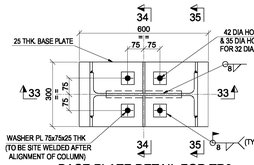

BASE PLATE DETAIL FOR TR3
(SCALE - 1:10)

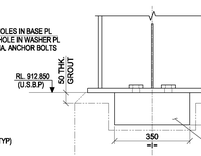

SECTION 33-33
(SCALE - 1:10)

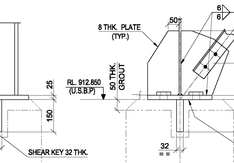

SECTION 34-34
(SCALE - 1:10)

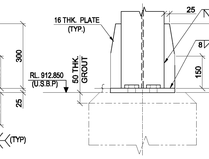

SECTION 35-35
(SCALE - 1:10)

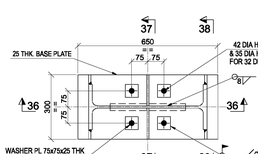

BASE PLATE DETAIL FOR TR4 & TR5
(SCALE - 1:10)

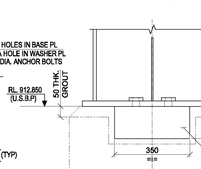

SECTION 36-36
(SCALE - 1:10)

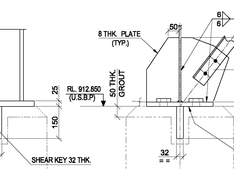

SECTION 37-37
(SCALE - 1:10)

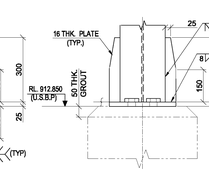

SECTION 38-38
(SCALE - 1:10)

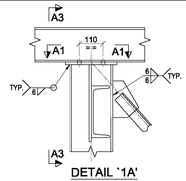

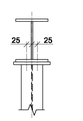

SECTION A3-A3
(SCALE 1:10)

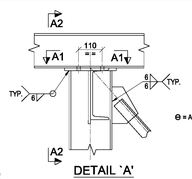

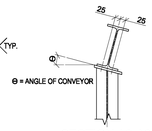

SECTION A2-A2
(SCALE 1:10)

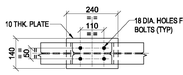

SECTION A1-A1
(SCALE 1:10)

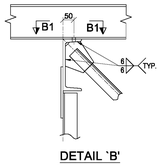

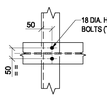

SECTION B1-B1
(SCALE 1:10)

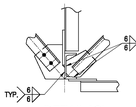

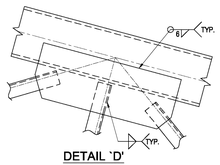

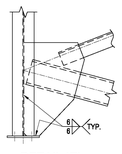

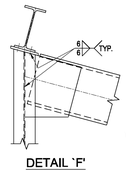

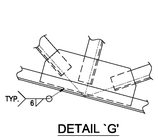

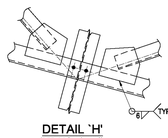

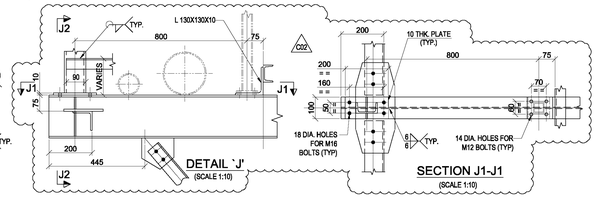

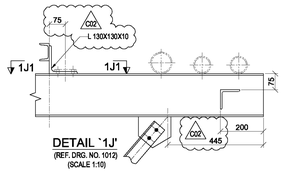

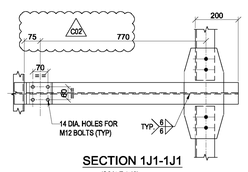

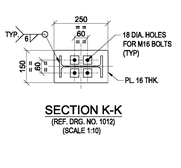

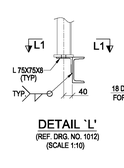

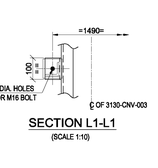

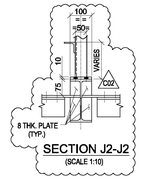

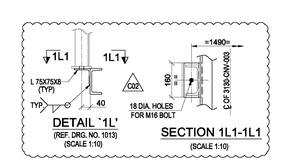

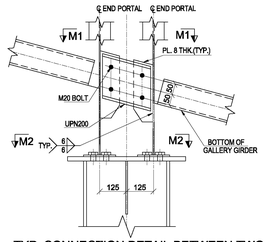

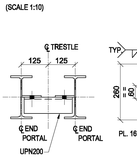

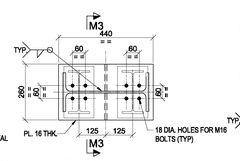

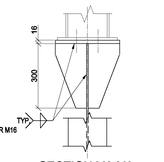

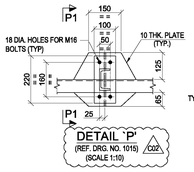

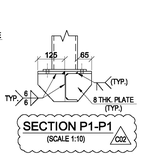

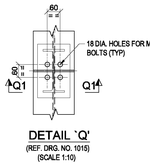

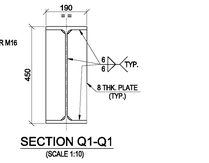

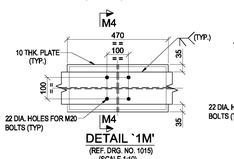

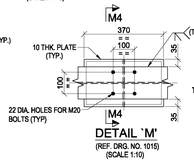

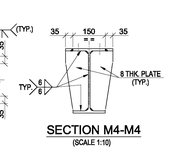

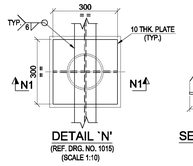

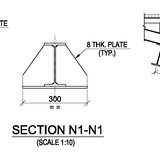

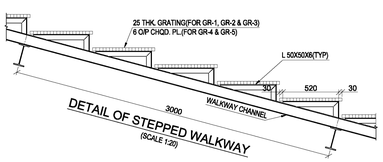

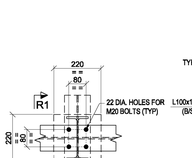

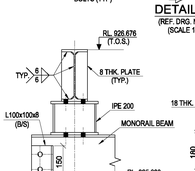

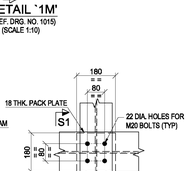

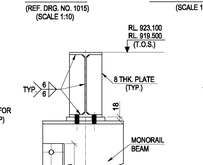

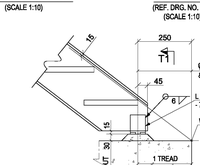

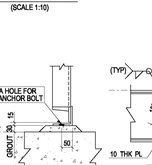

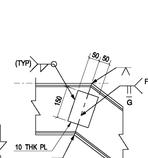

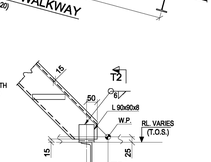

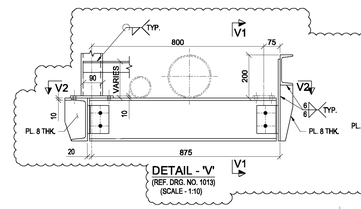

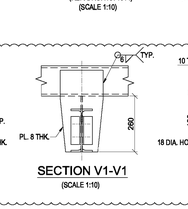

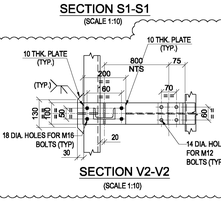

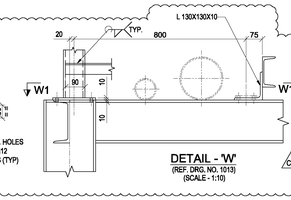

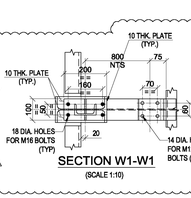

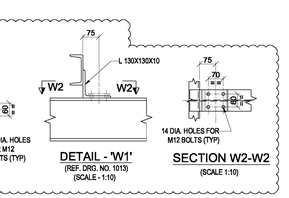

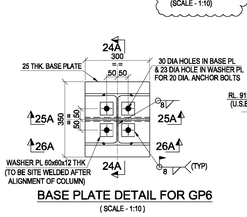

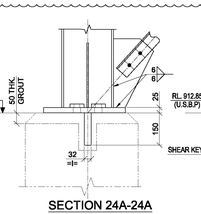

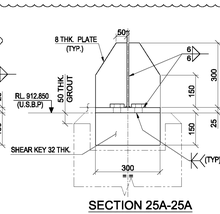

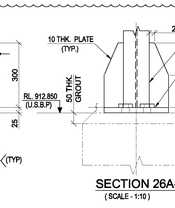

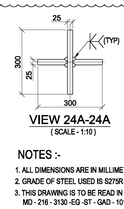

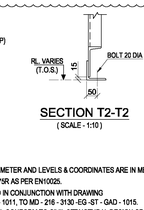

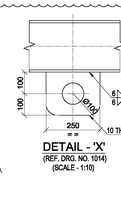

LEGEND :-
R.L - REDUCED LEVEL
℄ - CENTRE LINE
T.O.S. - TOP OF STEEL
F.G.L. - FINISHED GROUND LEVEL.
F.F.L. - FINISHED FLOOR LEVEL.
TYP. - TYPICAL
B.O.M.R. - BOTTOM OF MONORAIL.
MKD. - MARKED.
THK. - THICK
F/S - FAR SIDE
N/S - NEAR SIDE
W.P.-WORKING POINT
U.S.B.P. - UNDERSIDE OF BASE PLATE
U.N.O. - UNLESS NOTED OTHERWISE
T.O.W.W. - TOP OF WALKWAY
C/P - CUT FROM
REF. - REFER
DRG. NO. - DRAWING NUMBER

NOTES :-
1. ALL DIMENSIONS ARE IN MILLIMETER AND LEVELS & COORDINATES ARE IN METER UNO.
2. GRADE OF STEEL USED IS S275R AS PER EN10025.
3. THIS DRAWING IS TO BE READ IN CONJUNCTION WITH DRAWING
MD - 216 - 3130 -EG -ST - GAD - 1011, TO MD - 216 - 3130 -EG -ST - GAD - 1015.
4. ALL STRUCTURAL WORK SHALL CONFORM TO CIVIL STRUCTURAL DESIGN CRITARIYA NO
MD - 216 - 1000 -EG -ST - CRT - 1001

DOCUMENT NUMBER	REFERENCE DOCUMENTS	REV	DATE	REVISION DESCRIPTION	DRN	CHK	ENG	APP	EMP
		D01	31/10/2023	AS BUILT	MGH	SBY	APR	PRI	
MD-216-3120-EG-ME-LPX-1005	CONV. 3130-CNV-003-PLAN	C02	29/08/2020	ISSUED FOR CONSTRUCTION & REVISED AS MKD. C02	MGH	SBY	APR	PRI	
MD-216-3130-EG-ME-ELV-1009	CONV. 3130-CNV-003-ELEVATION	C01	01/06/2020	ISSUED FOR CONSTRUCTION, REVISED AS PER EMPLOYER	SUS	SBY	APR	PRI	
MD-216-3130-EG-ME-ELV-1010	CONV. 3130-CNV-003-ELEVATION			COMMENTS DATED 26/05/2020 & REVISED AS MARKED A01					
MD-216-3130-EG-ME-ELV-1011	CONV. 3130-CNV-003-ELEVATION	A01	30/03/2020	ISSUED FOR REFERENCE	SUS	SBY	APR	PRI	

RESERVED FOR VENDOR LOGO AND DRAWING NUMBER

LARSEN & TOUBRO

LARSEN & TOUBRO DRAWING NUMBER: 019045_100_S_G_26013_028 — REVISION 3
OUTOTEC DRAWING NUMBER: 900707__GAU01__ZC01_MTL01__31307 — DOCUMENT ID: OU100668059 — REVISION 3

DRAWN	SUS	25/03/2020
CHECKED	SBY	27/03/2020
ENGINEER	APR	26/03/2020
APPROVED	PRI	30/03/2020
EMPLOYER		
SCALE	1:100,50,20,10	A0

MANSOURAH - MASSARAH GOLD PROJECT
GENERAL ARRANGEMENT DRAWING
STRUCTURAL GA FOR 3130-CNV-003, SH6
PLAN, ELEVATIONS & DETAILS

DRAWING NUMBER: MD - 216 - 3130 - EG - ST - GAD - 1016 — REV: D01

The content of these documents are the sole property of Outotec Oyj. Any rights not expressly granted herein are reserved. Reproduction, transfer or distribution of part or all of the contents in any form without prior written permission of Outotec is prohibited.

This document and the information contained herein is Metsäden proprietary know-how. This document or any part thereof should not be reproduced, stored in a retrieval system or transmitted by any means, electronic or otherwise, or divulged without prior written permission of Metsäden.

REV D01

DRAWING NUMBER MD-216-3120-EG-ST-GAD-1020

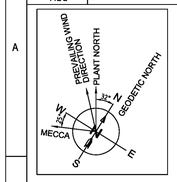

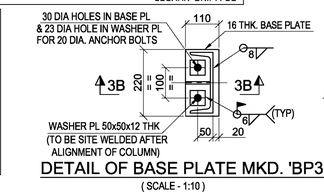

DETAIL OF BASE PLATE MKD. 'BP3'
(SCALE - 1:10)

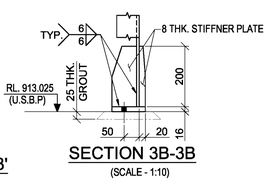

SECTION 3B-3B
(SCALE - 1:10)

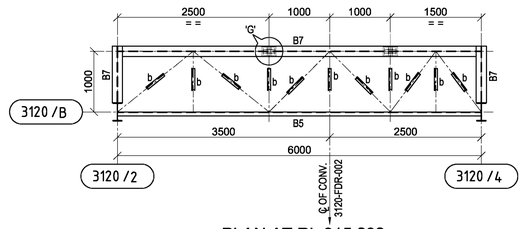

PLAN AT RL.915.282
(SCALE - 1:50)
(TOP OF FLOOR BRACING SHOULD BE KEPT 175mm BELOW T.O.S.)

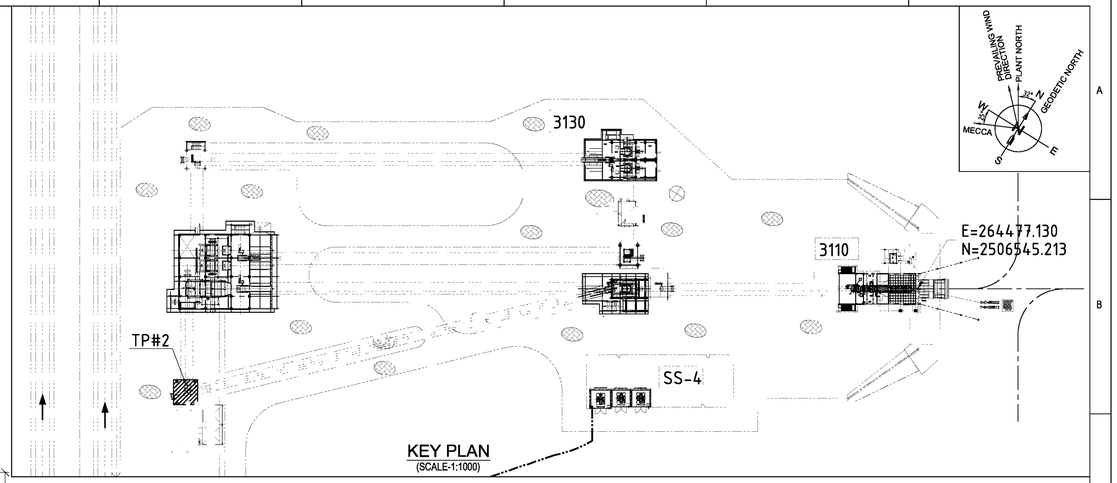

KEY PLAN
(SCALE-1:1000)

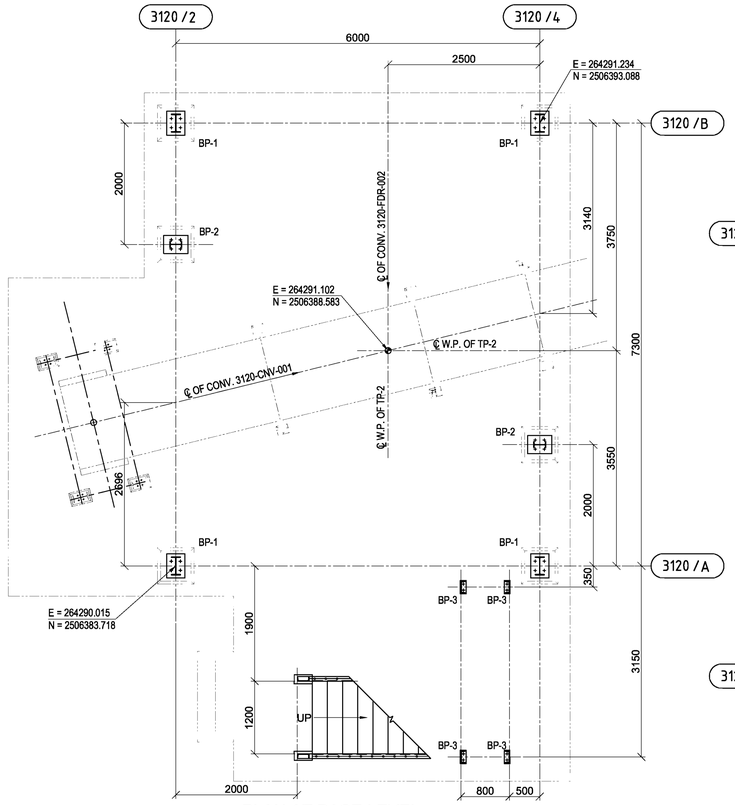

PLAN AT BASE LEVEL
(U/S OF BASE PLATE AT RL. 913.500 UNLESS NOTED OTHER WISE)
(SCALE - 1:50)

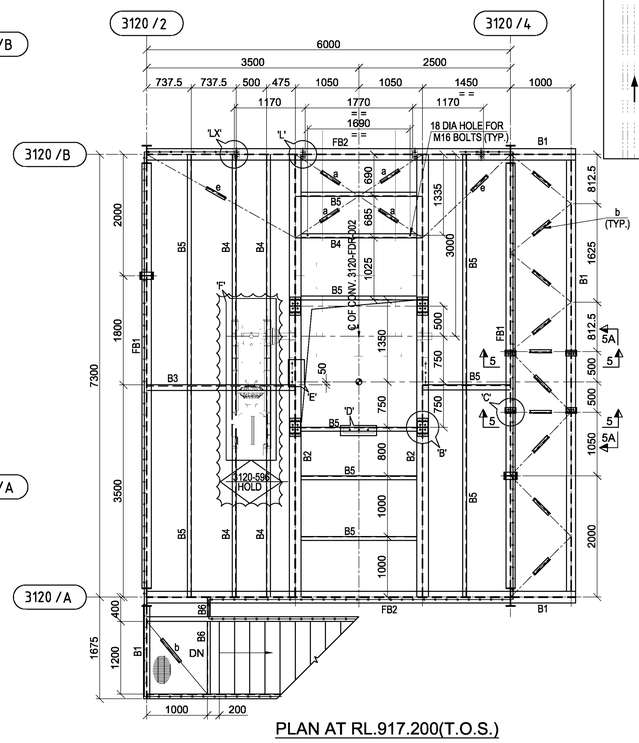

PLAN AT RL.917.200(T.O.S.)
(TOP OF FLOOR BRACING SHOULD BE KEPT 175mm BELOW T.O.S.)
(SCALE - 1:50)

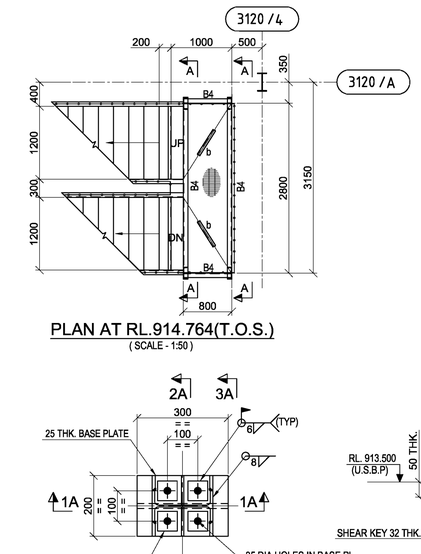

PLAN AT RL.914.764(T.O.S.)
(SCALE - 1:50)

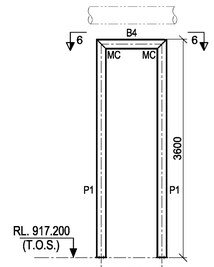

SECTION 5-5
(SCALE-1:50)

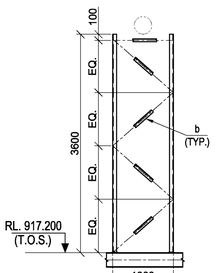

SECTION 5A-5A
(SCALE-1:50)

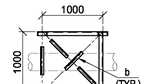

PLAN 6-6
(SCALE-1:50)

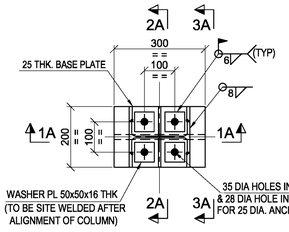

DETAIL OF BASE PLATE MKD. BP2
(SCALE - 1:10)

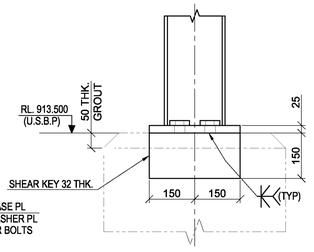

SECTION 1A-1A
(SCALE - 1:10)

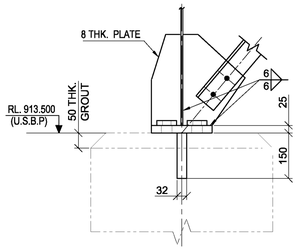

SECTION 2A-2A
(SCALE - 1:10)

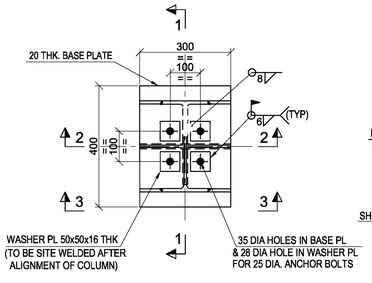

DETAIL OF BASE PLATE MKD. 'BP1'
(SCALE - 1:10)

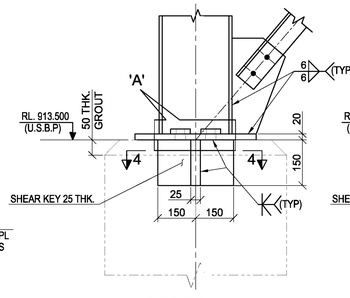

SECTION 1-1
(SCALE - 1:10)

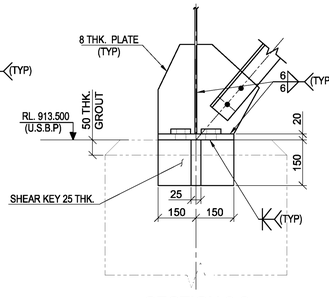

SECTION 2-2
(SCALE - 1:10)

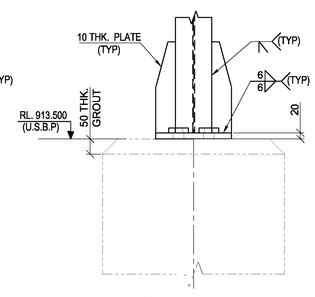

SECTION 3-3
(SCALE - 1:10)

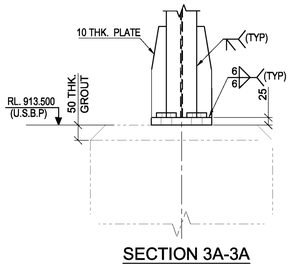

SECTION 3A-3A
(SCALE - 1:10)

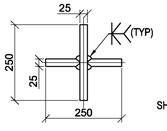

VIEW 4-4
(SCALE - 1:10)

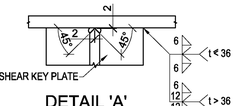

DETAIL 'A'
(SCALE - 1:10)

LEGEND :-
R.L. - REDUCED LEVEL
℄ - CENTRE LINE
T.O.S. - TOP OF STEEL.
F.G.L. - FINISHED GROUND LEVEL.
F.F.L. - FINISHED FLOOR LEVEL.
TYP. - TYPICAL
MKD. - MARKED.
THK. - THICK
W.P.-WORKING POINT
U.S.B.P. - UNDER SIDE OF BASE PLATE
U.N.O. - UNLESS NOTED OTHERWISE

NOTES :-
1. ALL DIMENSIONS ARE IN MILLIMETER AND LEVELS & COORDINATES ARE IN METER UNO.
2. GRADE OF STEEL USED IS S275R AS PER EN10025.
3. THIS DRAWING IS TO BE READ IN CONJUNCTION WITH DRAWING MD - 216 - 3130 -EG -ST - GAD - 1021.
4. ALL STRUCTURAL WORK SHALL CONFORM TO CIVIL STRUCTURAL DESIGN CRITERIA NO MD - 216 - 1000 -EG -ST - CRT - 1001

DOCUMENT NUMBER	REFERENCE DOCUMENTS	REV	DATE	REVISION DESCRIPTION	DRN	CHK	ENG	APP	EMP
		D01	31/10/2023	AS BUILT	SUS	SBY	APR	PRI	
MD-216-3120-EG-ME-LPX-1020	TRANSFER POINT TP#2 - PLAN VIEW	C01	11/05/2020	ISSUED FOR CONSTRUCTION	SUS	SBY	APR	PRI	
MD-216-3120-EG-ME-ELEV-1016	TRANSFER POINT TP#2 - ELEVATION	A01	15/04/2020	ISSUED FOR REFERENCE	SUS	SBY	APR	PRI	

RESERVED FOR VENDOR LOGO AND DRAWING NUMBER

LARSEN & TOUBRO

LARSEN & TOUBRO

The content of these documents are the sole property of Outotec Oyj. Any rights not expressly granted herein are reserved. Reproduction, transfer or distribution of part or all of the contents in any form without prior written permission of Outotec is prohibited.

This document and the information contained herein is Ma'aden proprietary know-how. This document or any part thereof should not be reproduced, stored in a retrieval system or transmitted by any means, electronic or otherwise, or divulged without prior written permission of Ma'aden.

LARSEN & TOUBRO DRAWING NUMBER	019045_100_S_G_26204_003		REVISION 2
OUTOTEC DRAWING NUMBER	900707__GAU01__ZC01__MTL01__31205	DOCUMENT ID OU100668070	REVISION 2

DRAWN	SUS	13/04/2020	MANSOURAH - MASSARAH GOLD PROJECT
CHECKED	SBY	14/04/2020	GENERAL ARRANGEMENT DRAWING
ENGINEER	APR	13/04/2020	STRUCTURAL GA OF TP-2(3120 CNV-001)-1
APPROVED	PRI	15/04/2020	PLAN, ELEVATIONS & DETAILS
EMPLOYER			
SCALE 1:100,20,15	A1		DRAWING NUMBER MD - 216 - 3120 - EG - ST - GAD - 1020 REV D01